SYMBOL LEGEND

NOTE: "EX" NEXT TO ANY SYMBOL ON DRAWING DESIGNATES AN EXISTING SIMILAR TYPE DEVICE

SYMBOL	PART NUMBER	DESCRIPTION	BACK BOX	BACK BOX SUPPLIER	MOUNTING HEIGHT
FACP	iO1000	FIRE ALARM CONTROL PANEL	SUPPLIED	FIRETROL PROTECTION SYSTEMS	APROX. 66" A.F.F. TO TOP
ANN	RLCD-C	REMOTE ANNUNCIATOR PANEL	4" SQUARE 2-1/8" BOX	ELECTRICAL CONTRACTOR	APROX. 60" A.F.F. TO TOP
BPSXA	BPS6A	BOOSTER POWER SUPPLY - 6AMP	SUPPLIED	FIRETROL PROTECTION SYSTEMS	APROX. 66" A.F.F. TO TOP
CELL	SLETEVI-CFB	CELLULAR/IP DUAL PATH COMMUNICATOR	SUPPLIED	FIRETROL PROTECTION SYSTEMS	66" A.F.F. TO TOP
DOC	MB3001	DOCUMENT STORAGE CABINET	SUPPLIED - 14.25" X 14.25" X 3.25"	FIRETROL PROTECTION SYSTEMS	AS REQUIRED - LOCATION VERIFIED BY OWNER
IN1 S	SIGA-CC1/S	SINGLE INPUT NAC MODULE	4" SQUARE W/ 2-GANG RING	ELECTRICAL CONTRACTOR	AS REQUIRED
	SIGA-OSD	PHOTOELECTRIC SMOKE DETECTOR	4" OCTAGON 2-1/8" DEEP	ELECTRICAL CONTRACTOR	CEILING
	SIGA-278	MANUAL PULL STATION	4" SQ. W/ SINGLE GANG RING	ELECTRICAL CONTRACTOR	48" A.F.F. TO CENTER
	SIGA-HRD	FIXED TEMP HEAT DETECTOR	4" OCTAGON 2-1/8" DEEP	ELECTRICAL CONTRACTOR	CEILING
S R	SIGA-SD	DUCT SMOKE DETECTOR S=SUPPLY R=RETURN FSD=FIRE/SMOKE DAMPER	SUPPLIED	FIRETROL PROTECTION SYSTEMS	DUCT SMOKE DETECTOR INSTALLED BY ELEC. OR MECH. CONTRACTOR (REF SPECS)
RT	SIGA-TRK	REMOTE TEST STATION (KEYED)	SINGLE GANG BOX	ELECTRICAL CONTRACTOR	48" A.F.F. TO CENTER
C	SIGA-CR	PROGRAMMABLE CONTROL RELAY	4" SQ. W/ SINGLE GANG RING	ELECTRICAL CONTRACTOR	AS REQUIRED
CH	SIGA-CRH	PROGRAMMABLE HIGH POWER CONTROL RELAY	4" SQ. W/ SINGLE GANG RING	ELECTRICAL CONTRACTOR	AS REQUIRED
M1	SIGA-CT1	SINGLE MONITOR MODULE	4" SQ. W/ SINGLE GANG RING	ELECTRICAL CONTRACTOR	AS REQUIRED
M2	SIGA-CT2	DUAL MONITOR MODULE	4" SQ. W/ SINGLE GANG RING	ELECTRICAL CONTRACTOR	AS REQUIRED
R1	MR101/C	MULTI-VOLTAGE CONTROL RELAY	PROVIDED	FIRETROL PROTECTION SYSTEMS	VARIES
J	N/A	JUNCTION BOX	4" SQUARE 2-1/8" BOX	ELECTRICAL CONTRACTOR	VARIES
SS 120	E120V-GT	120VAC SURGE PROTECTION MODULE	6"x6" BACKBOX	ELECTRICAL CONTRACTOR	AS NEEDED
WF	BY OTHERS	WATERFLOW - BY SPRINKLER CONTRACTOR	N/A	N/A	N/A
TS	BY OTHERS	TAMPER - BY SPRINKLER CONTRACTOR	N/A	N/A	N/A
	GCAVWF	CEILING MOUNT LED HORN STROBE (WHITE)	4" SQUARE 2-1/8" DEEP BOX	ELECTRICAL CONTRACTOR	CEILING
	G4AVWF	WALL MOUNT LED HORN STROBE (WHITE)	4" SQUARE 2-1/8" DEEP BOX	ELECTRICAL CONTRACTOR	82" A.F.F. TO BOTTOM
	GCVWF	CEILING MOUNT LED STROBE (WHITE)	4" SQUARE 2-1/8" DEEP BOX	ELECTRICAL CONTRACTOR	CEILING
	MBA-10-24	10" WEATHERPROOF BELL	BBK-1 WEATHERPROOF BOX	FIRETROL PROTECTION SYSTEMS	96" ABOVE CENTER OF F.D.C.
	RESISTOR	EOL RESISTOR - xx DESIGNATES OHM RATING	N/A	N/A	ON THE BACK OF THE END OF LINE DEVICE

WIRE LEGEND

- "A" = GREEN FPLP 18AWG 2COND. SIGNALING-LINE CIRCUIT
- "B" = RED FPLP 14AWG 2 COND. NOTIFICATION APPLIANCE CIRCUIT
- "E" = WHITE FPLP 16AWG 4COND. RS485(SBUS) COMMUNICATIONS & POWER CIRCUIT
- 3/4" CONDUIT UNLESS OTHERWISE NOTED ON DRAWINGS — 1A = WIRE TYPE WITHIN CONDUIT

HATCH LEGEND


- = NOT IN SCOPE OF WORK - ALL EQUIPMENT IN THESE AREAS ARE EXISTING UNLESS OTHERWISE NOTED.
- = SCOPE OF WORK - ALL EQUIPMENT SHOWN IN THESE AREAS ARE NEW UNLESS OTHERWISE NOTED.

RISER LEGEND

- RISER UP
- RISER DOWN
- RISER UP AND DOWN

*RISER CONDUITS ARE TYPICALLY 1" UNLESS OTHERWISE NOTED ON DRAWINGS

CIRCUIT NOTATION

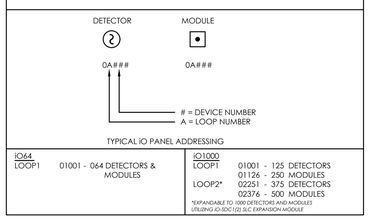


TYPICAL IO PANEL ADDRESSING

IO64		IO1000	
LOOP1	01001 - 064 DETECTORS & MODULES	LOOP1	01001 - 125 DETECTORS 01126 - 250 MODULES
		LOOP2*	02251 - 375 DETECTORS 02376 - 500 MODULES

*EXPANDABLE TO 1000 DETECTORS AND MODULES UTILIZING IO-SDCT (2) SLC EXPANSION MODULE


CIRCUIT NOTATION

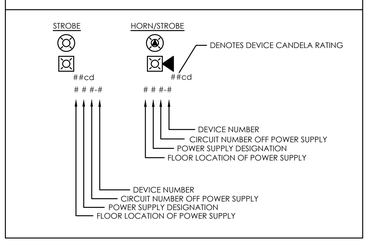

DRAWING INDEX

FA1.00	SYMBOL LEGEND, WIRE LEGEND, GENERAL NOTES, AND DESIGN CRITERIA
FA1.01	LEVEL 1A FIRE ALARM SYSTEM
FA1.02	LEVEL 1B FIRE ALARM SYSTEM
FA1.03	LEVEL 2 FIRE ALARM SYSTEM
FA2.02	FIRE ALARM SYSTEM RISER DIAGRAM

KEY PLAN

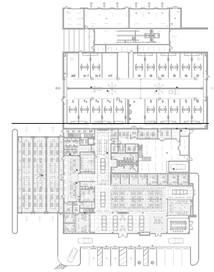

Fire Alarm Function Matrix (Input Description)	Outputs or Actions: Activate visual & audible Alarm indicators on FACP and initiate alarm signal to Central Station	Activate visual & audible Trouble indicators on FACP and initiate Trouble signal to Central Station	Activate visual & audible Supervisory indicators on FACP and initiate Supervisory signal to Central Station	Activate Horn/Strobes Throughout the Building.	Activate Dry Contacts to Shutdown HVAC Unit	Activate Dry Contacts to Initiate Primary Elevator Recall	Activate Dry Contacts to Initiate Alternate Elevator Recall	Activate Dry Contacts to Initiate Elevator Power Shunt/Trip (Program a Time Delay equal to Maximum Primary Recall Time)	Activate Dry Contacts to Light the Elevator Cab "FIRE" light.	Activate Water Flow Notification and Initiate Separate Alarm Signal to Central Station
Any System Smoke Detector	●			●						
Any System Heat Detector	●			●						
Elevator Lobby Smoke Detector 1st Floor	●			●			●			
Elevator Lobby Smoke Detector 2nd Floors	●			●		●				
Elevator Machine Room Smoke Detector Level 1	●			●		●			●	
Elevator Machine Room Heat Detector Level 1	●			●				●	●	
Top of Elevator Shaft Smoke Detector	●			●		●			●	
Loss of Power on Elevator Shunt/Trip			●							
Top Elevator Shaft Heat Detector	●			●				●		
Manual Pull Station	●			●						
Sprinkler Valve Tamper Switch			●							
Sprinkler Valve Waterflow Switch	●			●						●
Broken Wire on any F/A Circuit (ckt open)		●								
Ground Fault on any F/A Circuit		●								
Short on any F/A Circuit		●								
Loss of Communications to any intelligent F/A Device		●								
Loss of supervision on any circuit supervised by an intelligent F/A device.		●								
Sensitivity/Maintenance Issue w/ Any Intelligent Sensor			●							
Mechanically provided Duct Mounted Smoke Detector			●		2					

1 FIRE ALARM MATRIX

GENERAL NOTES

1. ALL DEVICES LOCATIONS SHOWN ARE BASED ON NFPA 72 OR ARE THE DESIGN CONCEPT OF THE ENGINEER OF RECORD. DO NOT DEVIATE FROM LOCATIONS SHOWN WITHOUT WRITTEN DIRECTION FROM FIRETROL. ANY DEVIATION WITHOUT WRITTEN DIRECTION MAY CAUSE THE SYSTEM TO BE NON-COMPLIANT.
2. 120VAC DEDICATED BRANCH CIRCUIT(S) AND CONNECTIONS SHALL BE PROTECTED AGAINST PHYSICAL DAMAGE. CIRCUIT DISCONNECT SHALL HAVE A RED MARKING, SHALL BE ACCESSIBLE ONLY TO AUTHORIZED PERSONNEL, AND SHALL BE IDENTIFIED AS "FIRE ALARM CIRCUIT" (NFPA 72, 2013) DEDICATED BRANCH CIRCUIT REQUIRED AT FIRE ALARM CONTROL PANEL AND BOOSTER PANELS.
3. ALL FIRE ALARM CIRCUITS ARE TO BE FREE OF GROUNDS AND SHORTS.
4. APPROPRIATE END OF LINE VALUE SHOULD BE READ PER CIRCUIT AT FACP.
5. USE NFPA 70 ARTICLE 760 FOR ALL FIRE ALARM WIRING.
6. FOLLOW ALL NATIONAL AND LOCAL CODES FOR MOUNTING AND INSTALLING DEVICES.
7. THERE ARE SOME APPLICATIONS THAT DO NOT REQUIRE FULL AREA PROTECTION, BUT DO REQUIRE DETECTION, TO INITIATE ACTION WHEN SPECIFIC OBJECTS OR SPACES ARE THREATENED BY SMOKE OR FIRE, SUCH AS AT ELEVATOR LANDINGS THAT HAVE CEILINGS IN EXCESS OF 15 ft (4.6m) AND FOR PROTECTION OF FIRE ALARM CONTROL UNITS. IN HIGH-CEILING AREAS, TO ACHIEVE THE DESIRED INITIATION, SUCH AS FOR ELEVATOR RECALL AND PROTECTION OF FIRE ALARM CONTROL UNITS (FACU'S), DETECTION SHOULD BE PLACED ON THE WALL ABOVE AND WITHIN 60 in (1.52m) FROM THE TOP OF THE ELEVATOR DOOR(S) OR FACU. - NFPA 72, 2013 EDITION, SECTION A17.4.10
8. **WHERE DETECTORS ARE INSTALLED FOR SIGNAL INITIATION DURING CONSTRUCTION, THEY SHALL BE CLEANED AND VERIFIED TO BE OPERATING IN ACCORDANCE WITH THE LISTED SENSITIVITY, OR THEY SHALL BE REPLACED PRIOR TO THE FINAL COMMISSIONING OF THE SYSTEM - NFPA 72, 2013 EDITION, SECTION 17.7.1.11.1**
9. **WHERE DETECTORS ARE INSTALLED BUT NOT OPERATIONAL DURING CONSTRUCTION, THEY SHALL BE PROTECTED FROM CONSTRUCTION DEBRIS, DUST, DIRT AND DAMAGE IN ACCORDANCE WITH THE MANUFACTURER'S RECOMMENDATIONS AND VERIFIED TO BE OPERATING IN ACCORDANCE WITH THE LISTED SENSITIVITY, OR THEY SHALL BE REPLACED PRIOR TO THE FINAL COMMISSIONING OF THE SYSTEM - NFPA 72, 2013 EDITION, SECTION 17.7.1.11.2**
10. "DETECTORS SHOULD NOT BE LOCATED IN A DIRECT AIRFLOW OR CLOSER THAN 36 in (910 mm) FROM AN AIR SUPPLY DIFFUSER OR RETURN AIR OPENING." - NFPA 72, 2013 EDITION, SECTION A.17.7.4.1
11. AUXILIARY RELAYS TO INITIATE CONTROL OF FIRE SAFETY FUNCTIONS SHALL BE LOCATED WITHIN 3 FEET OF THE CONTROLLED CIRCUIT OR DEVICE.
12. ALL CONDUIT AND CONDUIT STUBS MUST BE 3/4" UNLESS OTHERWISE NOTED ON DRAWINGS.
13. ALL CEILING HEIGHTS WHERE CEILING MOUNTED DEVICES ARE SHOWN, ARE 10 FEET ABOVE FINISHED FLOOR OR LESS UNLESS OTHERWISE NOTED ON DRAWINGS.
14. DUCT DETECTOR TUBES SHALL EXTEND ACROSS THE WIDTH OF THE DUCT AND PROTRUDE THROUGH THE OPPOSITE SIDE; AND BE PROVIDED WITH A REMOVABLE PLUG AT THE END OF THE SAMPLING TUBE.
15. CONCEALED DUCT DETECTORS SHALL BE PROVIDED WITH A PERMANENT LABEL LOCATED ON THE CEILING BELOW THE DETECTOR OR ON THE FLOOR ABOVE THE DETECTOR. THE LABEL SHALL HAVE THE DEVICE DESCRIPTION AND IDENTIFICATION ADDRESS.

APPLICABLE CODES

PROJECT IS DESIGNED IN COMPLIANCE WITH THE 2015 INTERNATIONAL BUILDING CODE.

FIRE	2015 IFC
BUILDING	2015 IBC
MECHANICAL	2015 IMC
ELECTRICAL	2014 NEC
NFPA72	2013 EDITION
CONSTRUCTION TYPE	11B, FULLY SPRINKLERED
OCCUPANCY	GROUP B BUSINESS, S-1 STORAGE

SCOPE OF WORK

FIRETROL TO INSTALL NEW FIRE ALARM SYSTEM INCLUDING; FIRE ALARM CONTROL PANEL, REMOTE ANNUNCIATION, REMOTE POWER SUPPLY'S, PULL STATION COVERAGE, SMOKE DETECTOR COVERAGE, HVAC INTERFACE, ELEVATOR INTERFACE, SPRINKLER MONITORING, AND NOTIFICATION COVERAGE IN ACCORDANCE WITH NFPA 72.

IMPORTANT

This drawing and the information and design application herein contained is the property of Firetrol Protection Systems, inc. and/or its subsidiaries and is loaned under the expressed conditions that the same be returned to Firetrol Protection Systems, Inc. upon request; all information herein contained shall be treated as secret and confidential; no reproduction of this drawing or any part thereof shall be made without the expressed written consent of Firetrol Protection Systems, Inc.

REV.	REVISIONS	DATE
1	AHJ COMMENTS	07-29-25
2	FIELD CHANGES	03-04-26
3		
4		
5		

☑ FOR SUBMITTAL ☐ RECORD DRAWINGS

I have reviewed these plans and

☑ certify that they comply with the applicable codes and standards.

Or

☐ certify they were copied from sealed engineering plans and any violations of the applicable codes or standards are specifically noted on these plans.

Firetrol Protection Systems, Inc.
4616 W. Howard Lane Suite 700
Austin, Texas 78728
Phone: 512-687-0115 ACR-1751168

APS Licensee Signature - APS-2129093 License #

DAN FELDMAN 03-04-2025
APS Printed name Date:

FIRETROL Protection Systems
FIRE PROTECTION AND LIFE SAFETY SPECIALISTS
SCR-0292 ACR-1751168
AUSTIN OFFICE
4616 W. Howard Lane Suite 700
Austin, Texas 78728
Call (512) 687-0115 • Fax (512) 687-0120
www.firetrol.net
Austin•Beaumont•Corpus Christi•Dallas•Fort Worth•Houston•La Porte•Lubbock•Mobile•Oklahoma City•Phoenix
Salt Lake City•San Antonio•Tucson•Tampa•Tyler•Waco

PROJECT: ROGER BEASLEY MAZDA LEANDER
9480 183A TOLL ROAD
LEANDER, TEXAS 78641

CONTRACT WITH: WIER COMMERCIAL CONSTRUCTION
3400 W. 34TH STREET
HOUSTON, TEXAS 77018


NEW GROUND UP CONSTRUCTION

DRAWING TITLE: FIRE ALARM SYSTEM

CONTRACT NUMBER:	PERMIT NUMBER:
47-005129	
DATE: 07-29-2025	DRAWN BY: SC
AHJ: AFD	CHECKED BY: DF

Sheet Number
1 of 5

Sheet Name
FA1.00
COVER SHEET
FIRE ALARM SYSTEM

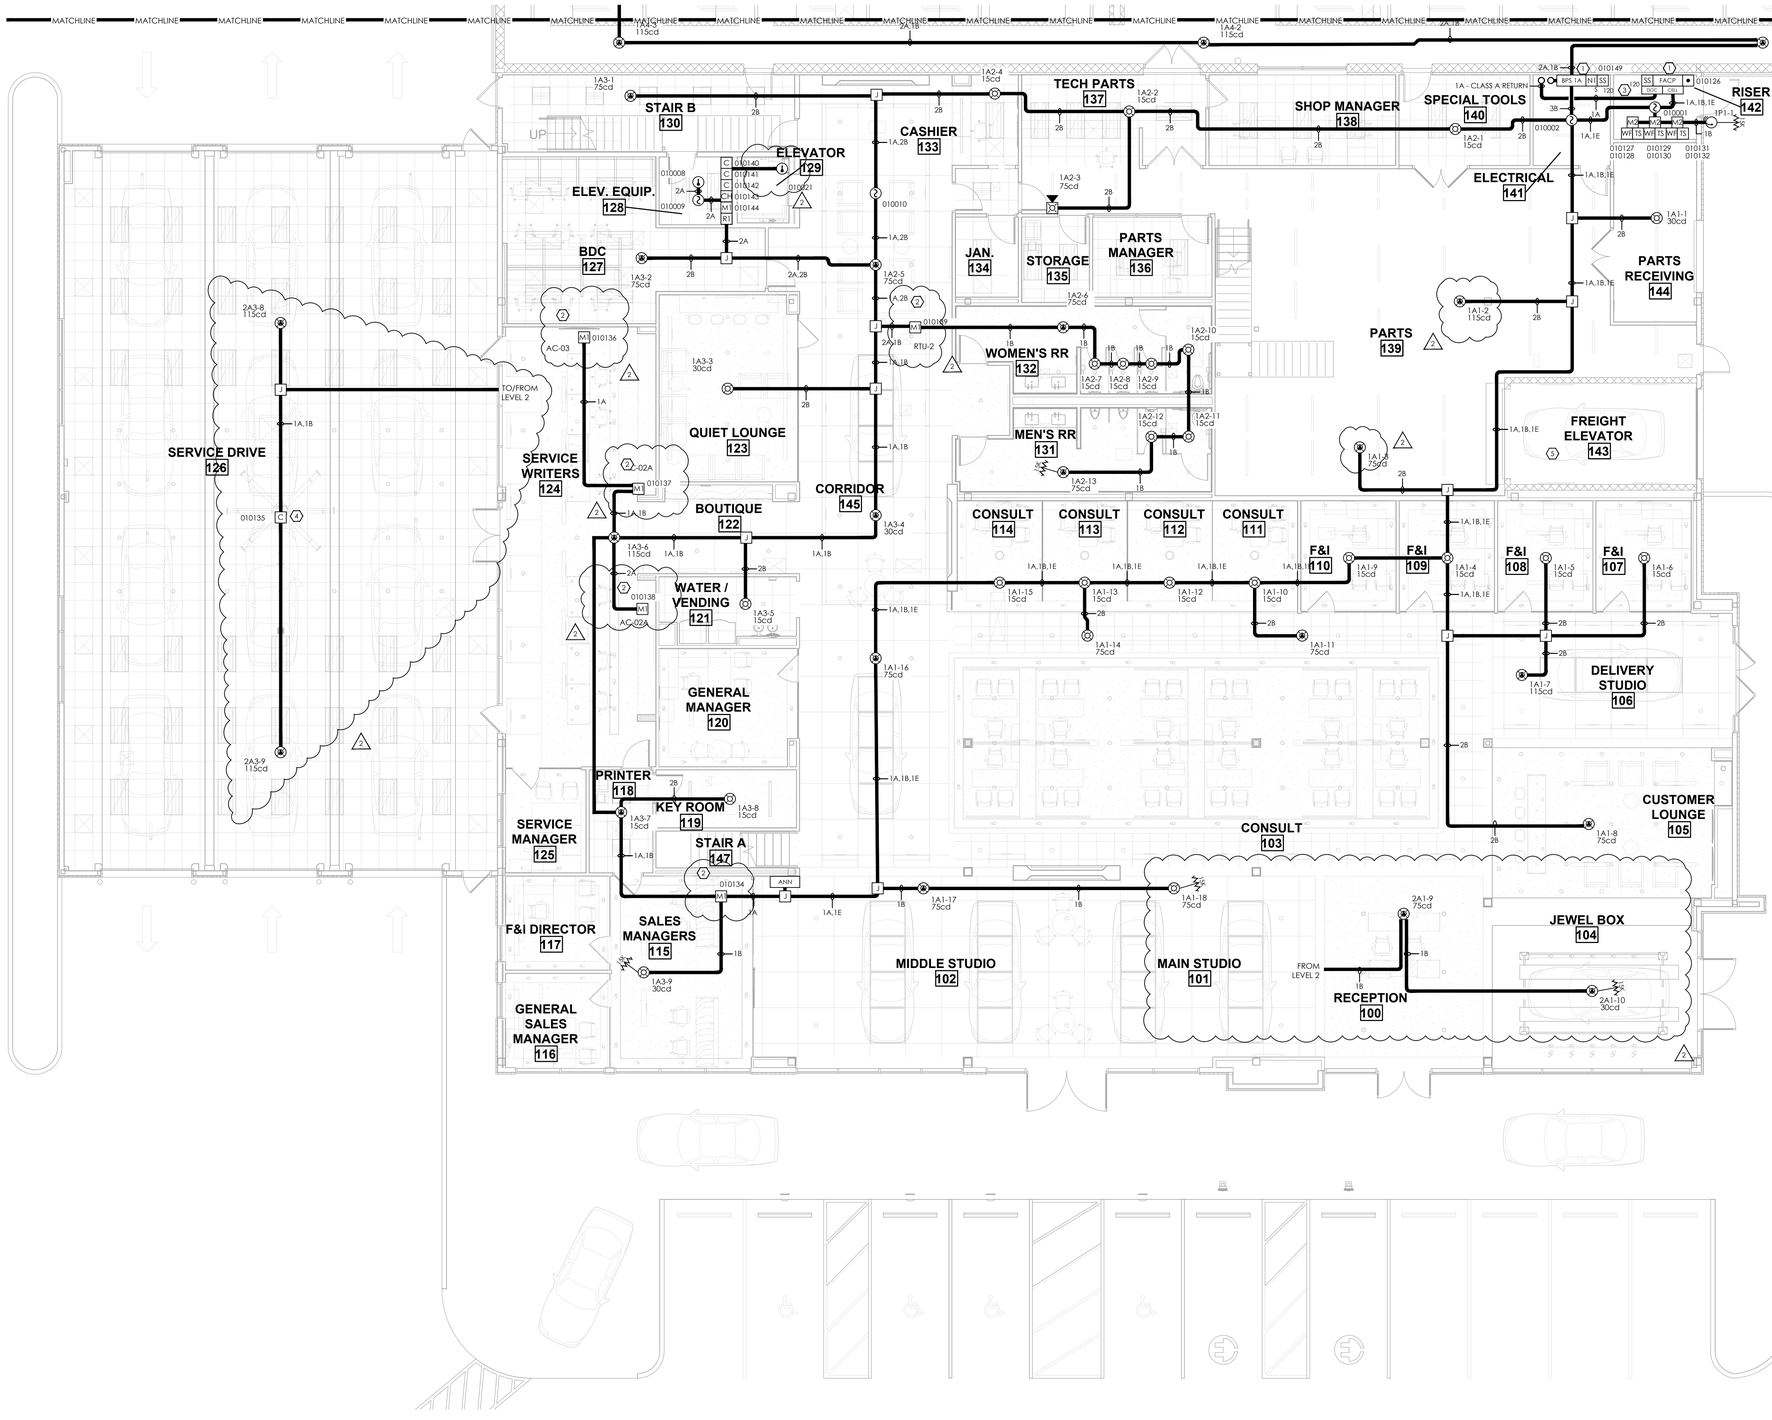


1 LEVEL 1A FIRE ALARM LAYOUT

0' 4' 8' 16'

1/8" = 1'-0"

KEY PLAN

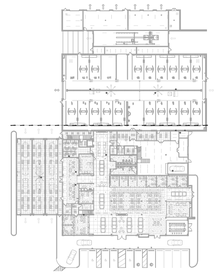

DRAWING NOTES

1. A. 120VAC DEDICATED BRANCH CIRCUIT REQUIRED. PROVIDED BY ELECTRICAL CONTRACTOR.
   B. 120VAC SURGE SUPPRESSION MODULE PROVIDED BY FIRETROL. INSTALLED BY ELECTRICAL CONTRACTOR.
2. MONITOR MODULE FOR MECHANICALLY PROVIDED DUCT DETECTOR
3. FIELD COORDINATE LOCATION OF DOCUMENT BOX AND CELL DIALER.
4. HVLS FAN SHUTDOWN RELAY. FIELD COORDINATE INTERFACE.
5. MECHANICAL LIFT. NO FIRE ALARM INTERFACE FOR RECALL/SHUNT.

IMPORTANT

This drawing and the information and design application herein contained is the property of Firetrol Protection Systems, inc. and/or its subsidiaries and is loaned under the expressed conditions that the same be returned to Firetrol Protection Systems, Inc. upon request; all information herein contained shall be treated as secret and confidential; no reproduction of this drawing or any part thereof shall be made without the expressed written consent of Firetrol Protection Systems, Inc.

REV.	REVISIONS	DATE
1	AHJ COMMENTS	07-29-25
2	FIELD CHANGES	03-04-26
3		
4		
5		

☑ FOR SUBMITTAL ☐ RECORD DRAWINGS

I have reviewed these plans and

☑ certify that they comply with the applicable codes and standards.

Or

☐ certify they were copied from sealed engineering plans and any violations of the applicable codes or standards are specifically noted on these plans.

Firetrol Protection Systems, Inc.
4616 W. Howard Lane Suite 700
Austin, Texas 78728
Phone: 512-687-0115 ACR-1751168

APS Licensee Signature — APS-2129093 License #

DAN FELDMAN 03-04-2025
APS Printed name Date:

FIRETROL Protection Systems
FIRE PROTECTION AND LIFE SAFETY SPECIALISTS
SCR-0292 ACR-1751168
AUSTIN OFFICE
4616 W. Howard Lane Suite 700
Austin, Texas 78728
call (512) 687-0115 • fax (512) 687-0120
www.firetrol.net
Austin•Beaumont•Corpus Christi•Dallas•Fort Worth•Houston•La Porte•Lubbock•Mobile•Oklahoma City•Phoenix
Salt Lake City•San Antonio•Tucson•Temple•Tyler•Waco

PROJECT: ROGER BEASLEY MAZDA LEANDER
9480 183A TOLL ROAD
LEANDER, TEXAS 78641

CONTRACT WITH: WIER COMMERCIAL CONSTRUCTION
3400 W. 34TH STREET
HOUSTON, TEXAS 77018


DRAWING TITLE: FIRE ALARM SYSTEM

NEW GROUND UP CONSTRUCTION

CONTRACT NUMBER:	PERMIT NUMBER:
47-005129	
DATE: 07-29-2025	DRAWN BY: SC
AHJ: AFD	CHECKED BY: DF

Sheet Number
2 of 5

Sheet Name
FA1.01
LEVEL 1A
FIRE ALARM SYSTEM

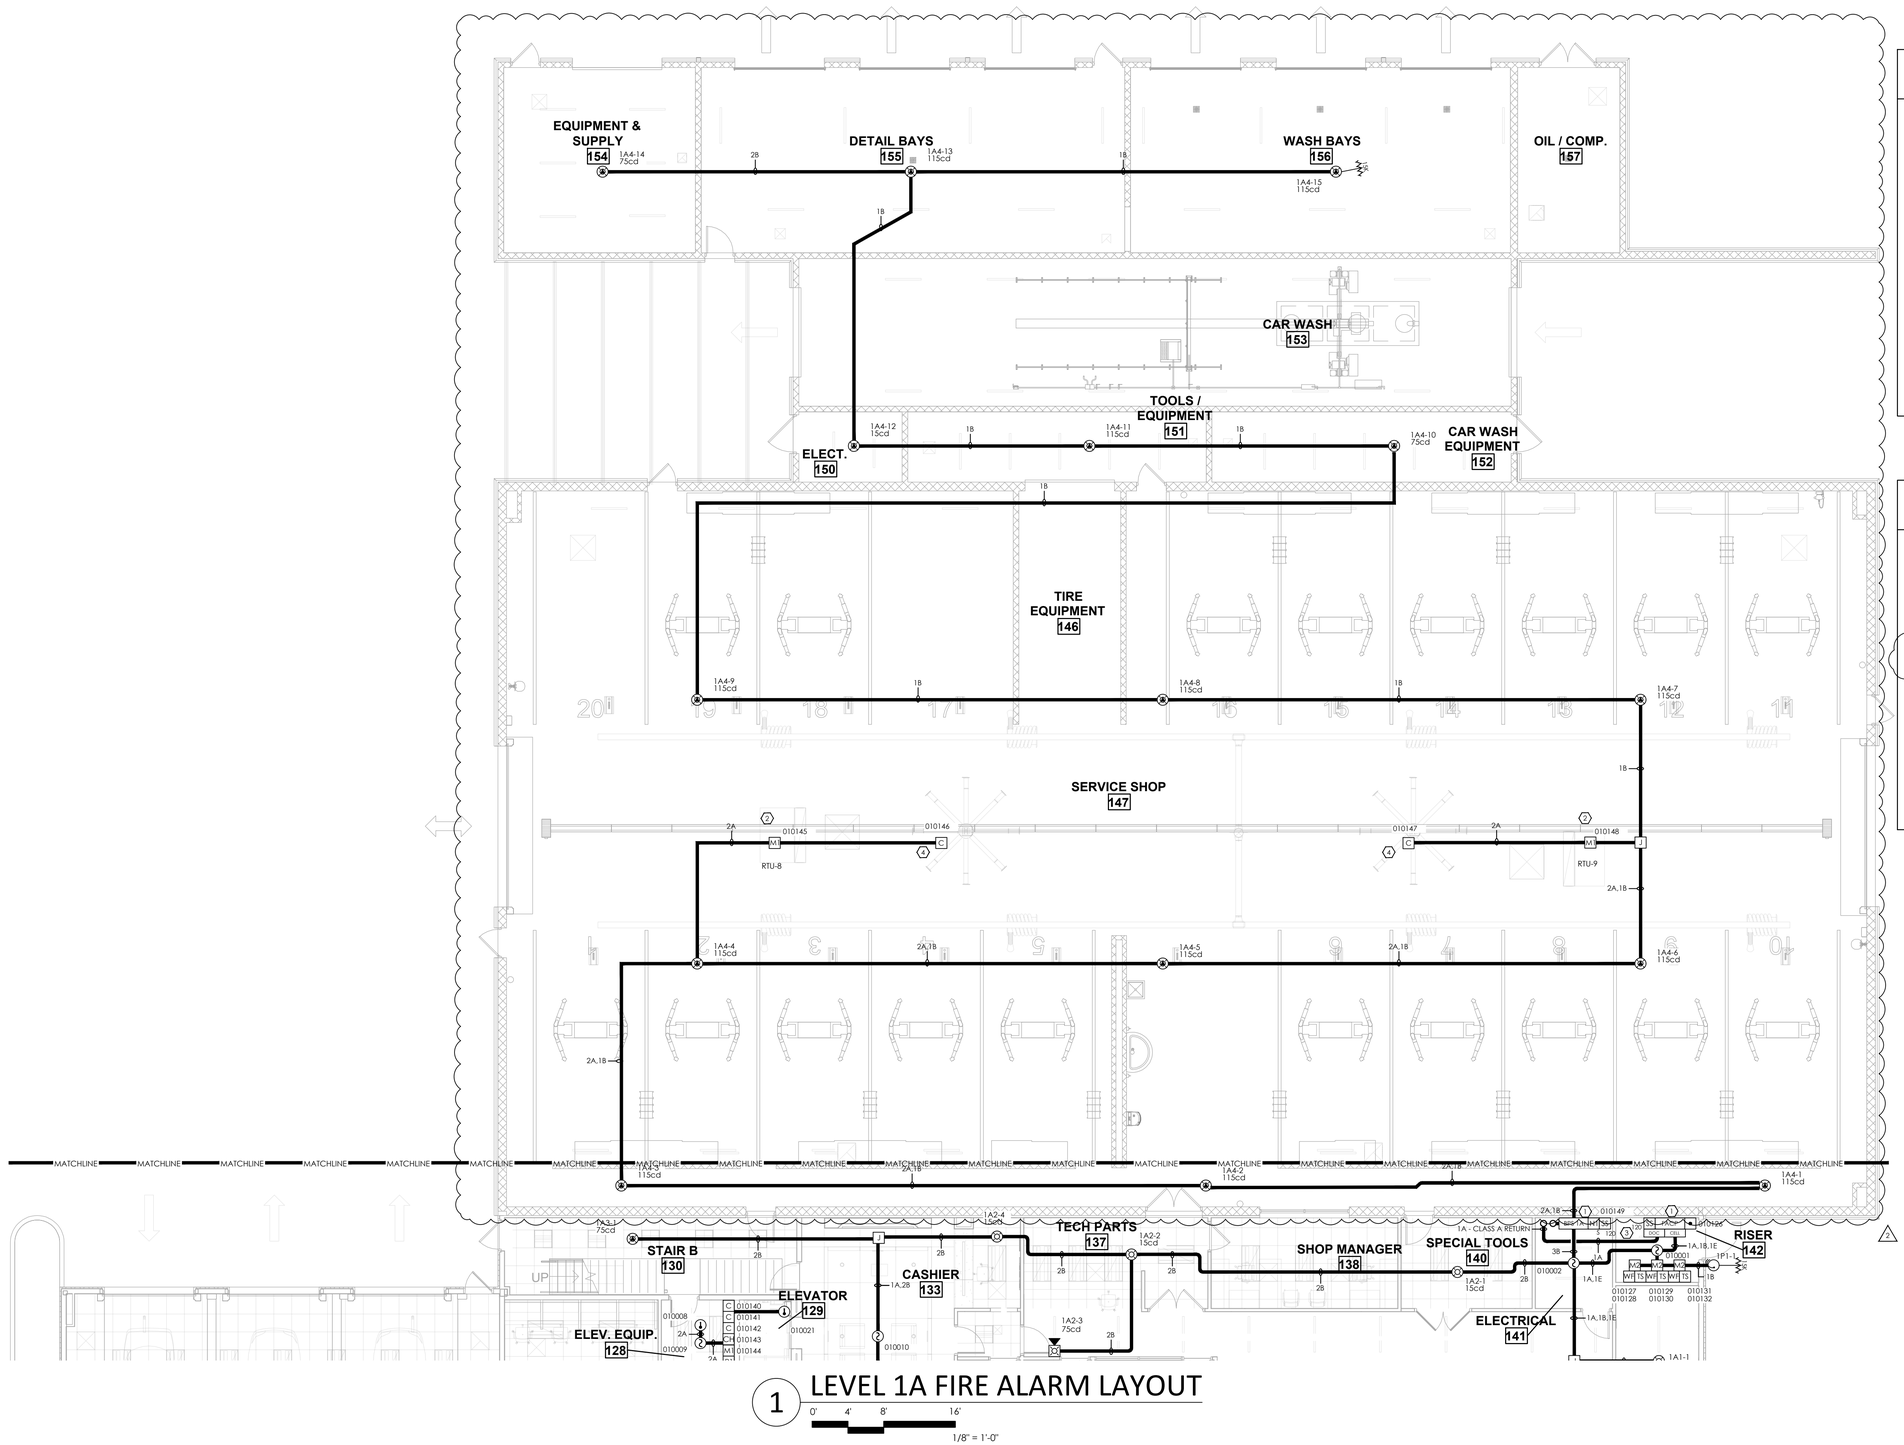


1 LEVEL 1A FIRE ALARM LAYOUT

0' 4' 8' 16'

1/8" = 1'-0"

KEY PLAN

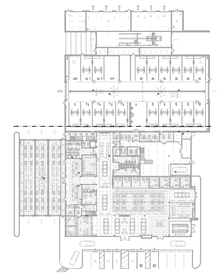

DRAWING NOTES

1. A. 120VAC DEDICATED BRANCH CIRCUIT REQUIRED. PROVIDED BY ELECTRICAL CONTRACTOR.
   B. 120VAC SURGE SUPPRESSION MODULE PROVIDED BY FIRETROL. INSTALLED BY ELECTRICAL CONTRACTOR.
2. MONITOR MODULE FOR MECHANICALLY PROVIDED DUCT DETECTOR
3. FIELD COORDINATE LOCATION OF DOCUMENT BOX AND CELL DIALER.
4. HVLS FAN SHUTDOWN RELAY. FIELD COORDINATE INTERFACE.
5. MECHANICAL LIFT. NO FIRE ALARM INTERFACE FOR RECALL/SHUNT.

IMPORTANT
This drawing and the information and design application herein contained is the property of Firetrol Protection Systems, inc. and/or its subsidiaries and is loaned under the expressed conditions that the same be returned to Firetrol Protection Systems, Inc. upon request; all information herein contained shall be treated as secret and confidential; no reproduction of this drawing or any part thereof shall be made without the expressed written consent of Firetrol Protection Systems, Inc.

REV.	REVISIONS	DATE
1	AHJ COMMENTS	07-29-25
2	FIELD CHANGES	03-04-26
3		
4		
5		

☑ FOR SUBMITTAL ☐ RECORD DRAWINGS

I have reviewed these plans and

☑ certify that they comply with the applicable codes and standards.

Or

☐ certify they were copied from sealed engineering plans and any violations of the applicable codes or standards are specifically noted on these plans.

Firetrol Protection Systems, Inc.
4616 W. Howard Lane Suite 700
Austin, Texas 78728
Phone: 512-687-0115 ACR-1751168

APS Licensee Signature - APS-2129093 License #

DAN FELDMAN 03-04-2025
APS Printed name Date:

FIRETROL Protection Systems
FIRE PROTECTION AND LIFE SAFETY SPECIALISTS
SCR-0292 ACR-1751168
AUSTIN OFFICE
4616 W. Howard Lane Suite 700
Austin, Texas 78728
call (512) 687-0115 • fax (512) 687-0120
www.firetrol.net
Austin•Beaumont•Corpus Christi•Dallas•Fort Worth•Houston•La Porte•Lubbock•Mobile•Oklahoma City•Phoenix
Salt Lake City•San Antonio•Tucson•Tampa•Tyler•Waco

PROJECT: ROGER BEASLEY MAZDA LEANDER
9480 183A TOLL ROAD
LEANDER, TEXAS 78641


CONTRACT WITH: WIER COMMERCIAL CONSTRUCTION
3400 W. 34TH STREET
HOUSTON, TEXAS 77018

DRAWING TITLE: NEW GROUND UP CONSTRUCTION
FIRE ALARM SYSTEM

CONTRACT NUMBER:	PERMIT NUMBER:
47-005129	
DATE: 07-29-2025	DRAWN BY: SC
AHJ: AFD	CHECKED BY: DF

Sheet Number
3 of 5

Sheet Name
FA1.02
LEVEL 1B
FIRE ALARM SYSTEM

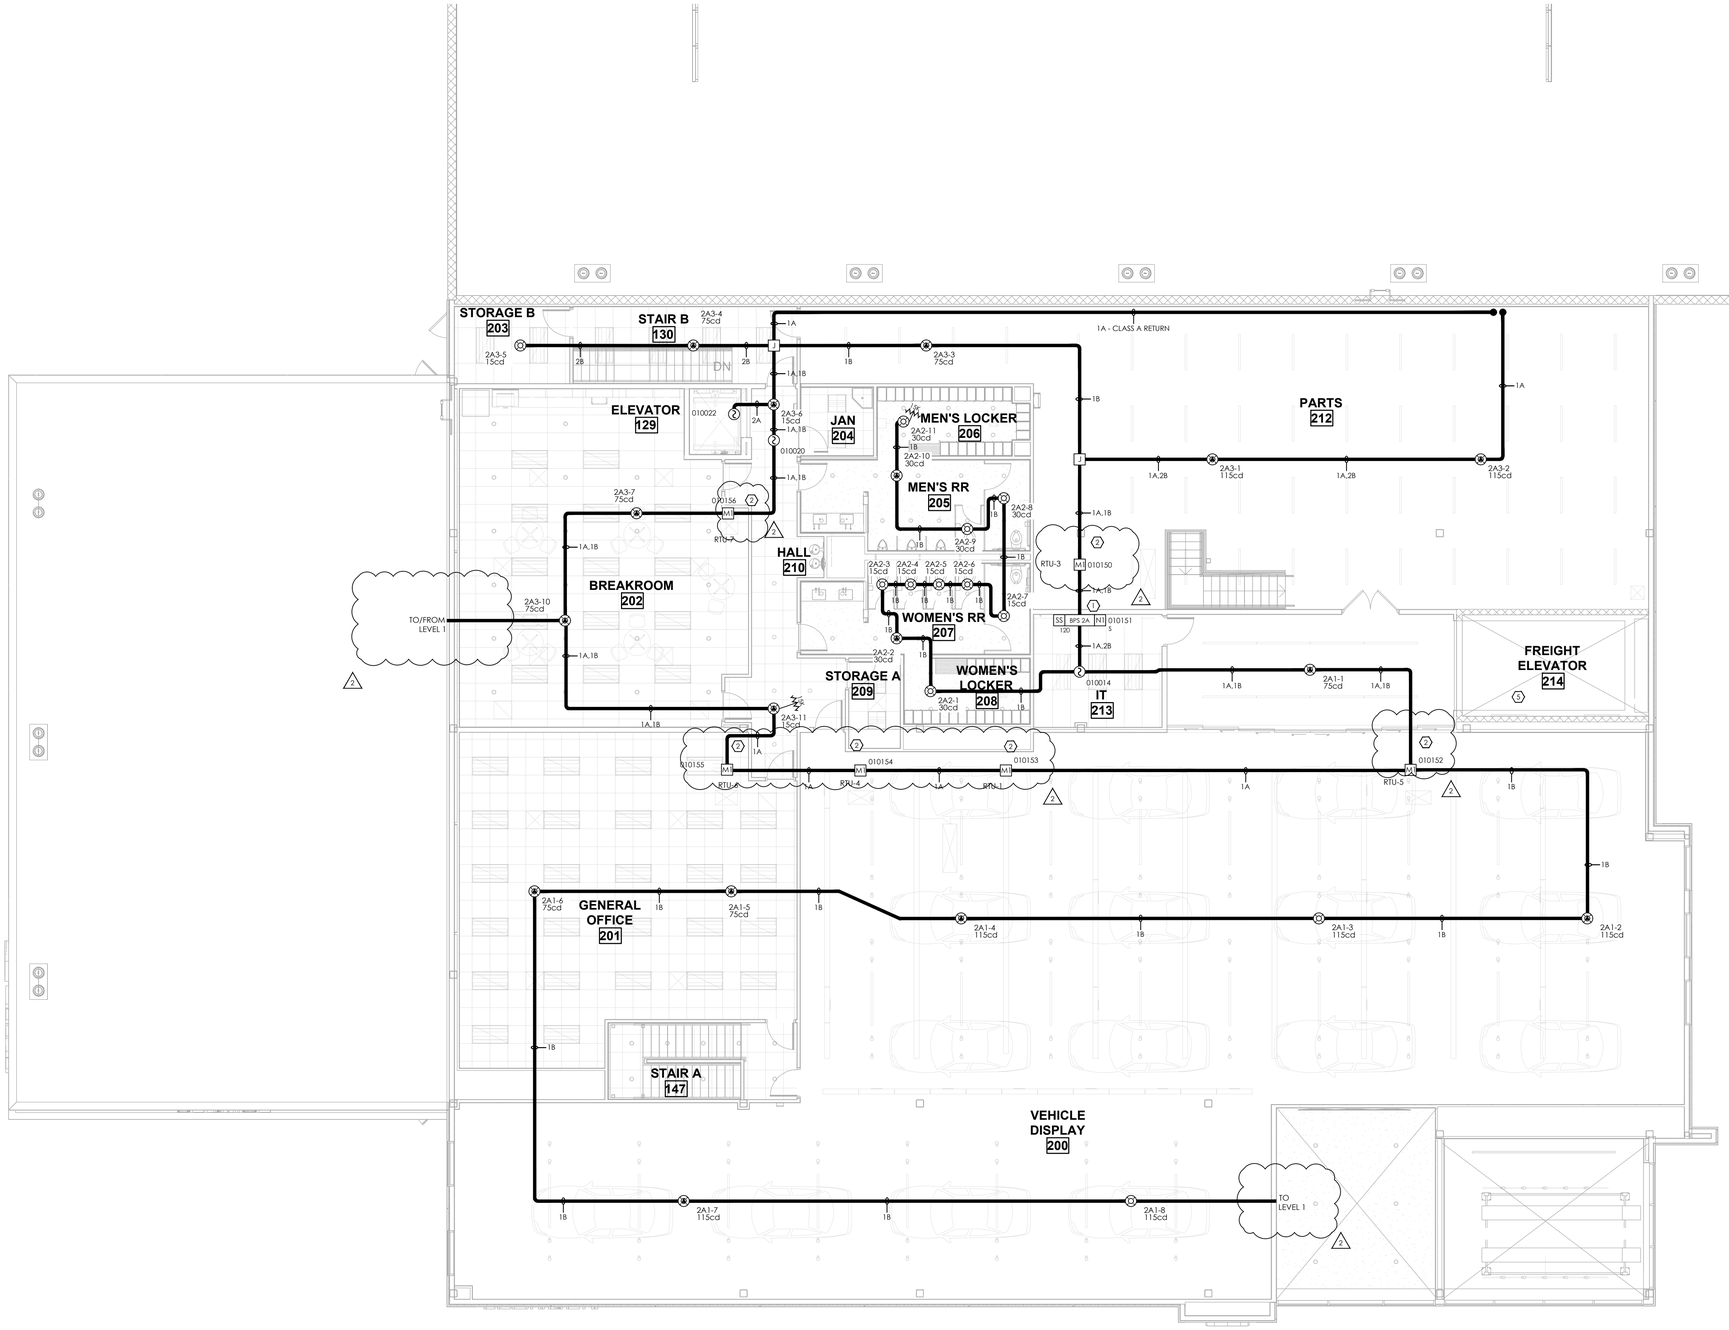

1 LEVEL 2 FIRE ALARM LAYOUT


0' 4' 8' 16'

1/8" = 1'-0"

IMPORTANT
This drawing and the information and design application herein contained is the property of Firetrol Protection Systems, inc. and/or its subsidiaries and is loaned under the expressed conditions that the same be returned to Firetrol Protection Systems, Inc. upon request; all information herein contained shall be treated as secret and confidential; no reproduction of this drawing or any part thereof shall be made without the expressed written consent of Firetrol Protection Systems, Inc.

REV.	REVISIONS	DATE
1	AHJ COMMENTS	07-29-25
2	FIELD CHANGES	03-04-26
3		
4		
5		

KEY PLAN

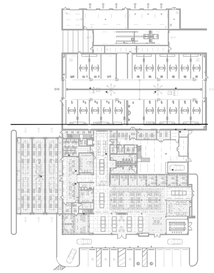

DRAWING NOTES

1. A. 120VAC DEDICATED BRANCH CIRCUIT REQUIRED. PROVIDED BY ELECTRICAL CONTRACTOR.
   B. 120VAC SURGE SUPPRESSION MODULE PROVIDED BY FIRETROL. INSTALLED BY ELECTRICAL CONTRACTOR.
2. MONITOR MODULE FOR MECHANICALLY PROVIDED DUCT DETECTOR
3. FIELD COORDINATE LOCATION OF DOCUMENT BOX AND CELL DIALER.
4. HVLS FAN SHUTDOWN RELAY. FIELD COORDINATE INTERFACE.
5. MECHANICAL LIFT. NO FIRE ALARM INTERFACE FOR RECALL/SHUNT.

FOR SUBMITTAL ☐ RECORD DRAWINGS

I have reviewed these plans and certify that they comply with the applicable codes and standards.

Or

☐ certify they were copied from sealed engineering plans and any violations of the applicable codes or standards are specifically noted on these plans.

Firetrol Protection Systems, Inc.
4616 W. Howard Lane Suite 700
Austin, Texas 78728
Phone: 512-687-0115 ACR-1751168

APS License Signature APS License # APS-2129093

DAN FELDMAN 03-04-2025
APS Printed name Date:

FIRETROL Protection Systems
FIRE PROTECTION AND LIFE SAFETY SPECIALISTS
SCR-0292 ACR-1751168
AUSTIN OFFICE
4616 W. Howard Lane Suite 700
Austin, Texas 78728
call (512) 687-0115 • fax (512) 687-0120
www.firetrol.net
Austin•Beaumont•Corpus Christi•Dallas•Fort Worth•Houston•La Porte•Lubbock•Mobile•Oklahoma City•Phoenix
Salt Lake City•San Antonio•Tucson•Tampa•Tyler•Waco

PROJECT: ROGER BEASLEY MAZDA LEANDER
9480 183A TOLL ROAD
LEANDER, TEXAS 78641

CONTRACT WITH: WIER COMMERCIAL CONSTRUCTION
3400 W. 34TH STREET
HOUSTON, TEXAS 77018


NEW GROUND UP CONSTRUCTION

DRAWING TITLE: FIRE ALARM SYSTEM

CONTRACT NUMBER:	PERMIT NUMBER:
47-005129	
DATE: 07-29-2025	DRAWN BY: SC
AHJ: AFD	CHECKED BY: DF

Sheet Number
4 of 5

Sheet Name
FA1.03
LEVEL 2
FIRE ALARM SYSTEM

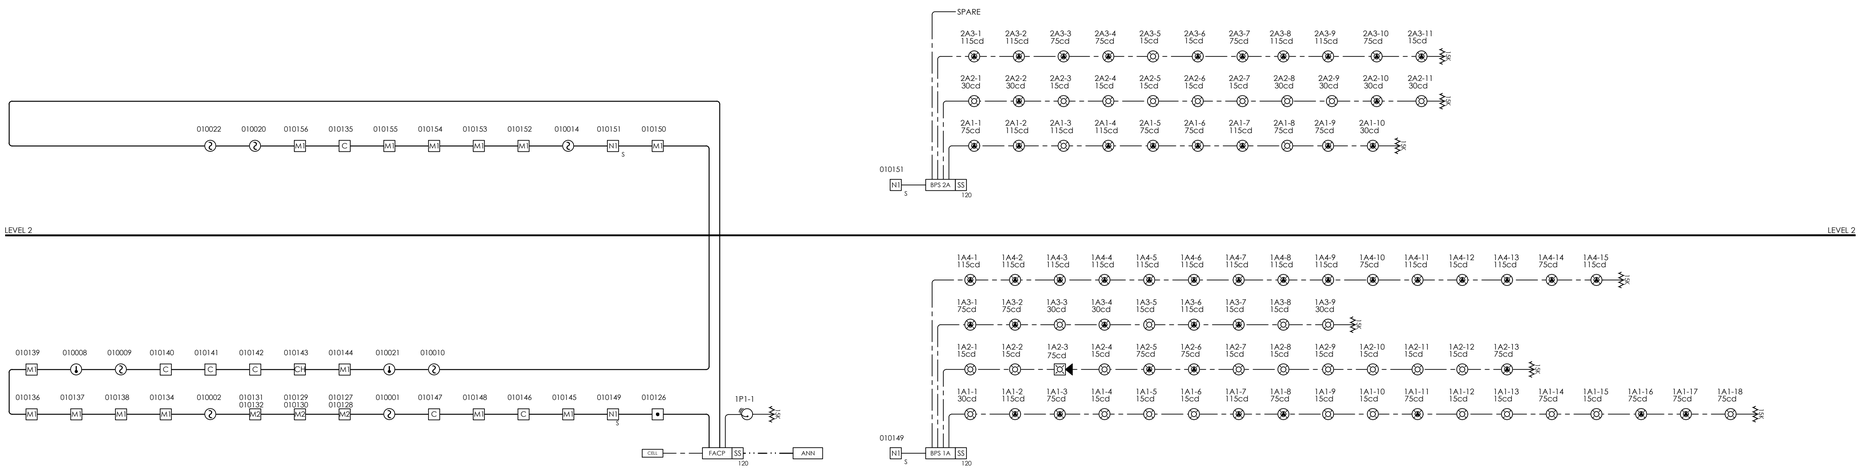

1 RISER DIAGRAM

IMPORTANT

This drawing and the information and design application herein contained is the property of Firetrol Protection Systems, inc. and/or its subsidiaries and is loaned under the expressed conditions that the same be returned to Firetrol Protection Systems, Inc. upon request; all information herein contained shall be treated as secret and confidential; no reproduction of this drawing or any part thereof shall be made without the expressed written consent of Firetrol Protection Systems, Inc.

REV.	REVISIONS	DATE
1	AHJ COMMENTS	07-29-25
2	FIELD CHANGES	03-04-26
3		
4		
5		

☑ FOR SUBMITTAL ☐ RECORD DRAWINGS

I have reviewed these plans and

☑ certify that they comply with the applicable codes and standards.

Or

☐ certify they were copied from sealed engineering plans and any violations of the applicable codes or standards are specifically noted on these plans.

Firetrol Protection Systems, Inc.
4616 W. Howard Lane Suite 700
Austin, Texas 78728
Phone: 512-687-0115 ACR-1751168

APS Licensee Signature - APS License # APS-2129093

DAN FELDMAN 03-04-2025
APS Printed name Date:

FIRETROL Protection Systems
FIRE PROTECTION AND LIFE SAFETY SPECIALISTS
SCR-0292 ACR-1751168

AUSTIN OFFICE
4616 W. Howard Lane Suite 700
Austin, Texas 78728
call (512) 687-0115 • fax (512) 687-0120
www.firetrol.net

Austin•Beaumont•Corpus Christi•Dallas•Fort Worth•Houston•La Porte•Lubbock•Mobile•Oklahoma City•Phoenix
Salt Lake City•San Antonio•Tucson•Tampa•Tyler•Waco

PROJECT: ROGER BEASLEY MAZDA LEANDER
9480 183A TOLL ROAD
LEANDER, TEXAS 78641

CONTRACT WITH: WIER COMMERCIAL CONSTRUCTION
3400 W. 34TH STREET
HOUSTON, TEXAS 77018

NEW GROUND UP CONSTRUCTION

DRAWING TITLE: FIRE ALARM SYSTEM

CONTRACT NUMBER:	PERMIT NUMBER:
47-005129	
DATE: 07-29-2025	DRAWN BY: SC
AHJ: AFD	CHECKED BY: DF

Sheet Number
5 of 5

Sheet Name
FA2.00
RISER DIAGRAM
FIRE ALARM SYSTEM